



MATCH LINE SEE DWG'S C12 & C13

**KEYNOTES:**

- ① TREATMENT PLANT ACCESS ROAD - SEE PROFILE ON DRAWING NO.'S C20 AND C21; TYPICAL SECTIONS SHOWN ON DRAWING NO. C25
- ② EXISTING TREATMENT PLANT ACCESS ROAD SHALL BE OVERLAID WITH 2 INCHES OF ASPHALT
- ③ EXISTING PARKING LOT SHALL BE OVERLAID WITH 2 INCHES OF ASPHALT
- ④ INSTALL CHAIN LINK FENCE - FOR LIMITS OF NEW FENCING SEE DRAWING NO. 04; FOR DETAILS OF FENCING SEE DRAWING NO. C28
- ⑤ SIDEWALK REPLACEMENT - SEE DETAIL ON DRAWING NO. C25
- ⑥ PARKING LOT SHALL BE RECONSTRUCTED WITH 4 INCHES OF ASPHALT AND 8 INCHES OF BASE
- ⑦ ALL DISTURBED AREAS TO BE REVEGETATED IN ACCORDANCE WITH THE SPECIFICATIONS
- ⑧ SEE PROFILE OF SOLIDS HANDLING BASINS ON DRAWING NO. C27
- ⑨ 12' SWING GATE - SEE DETAIL D ON DRAWING NO. C28
- ⑩ SOLIDS HANDLING BASINS ACCESS ROAD - 6" GRAVEL SURFACING

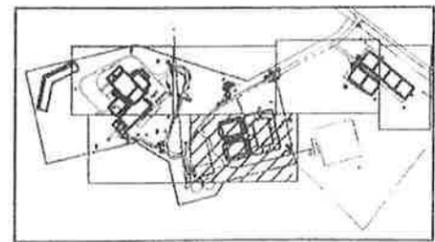

KEY PLAN

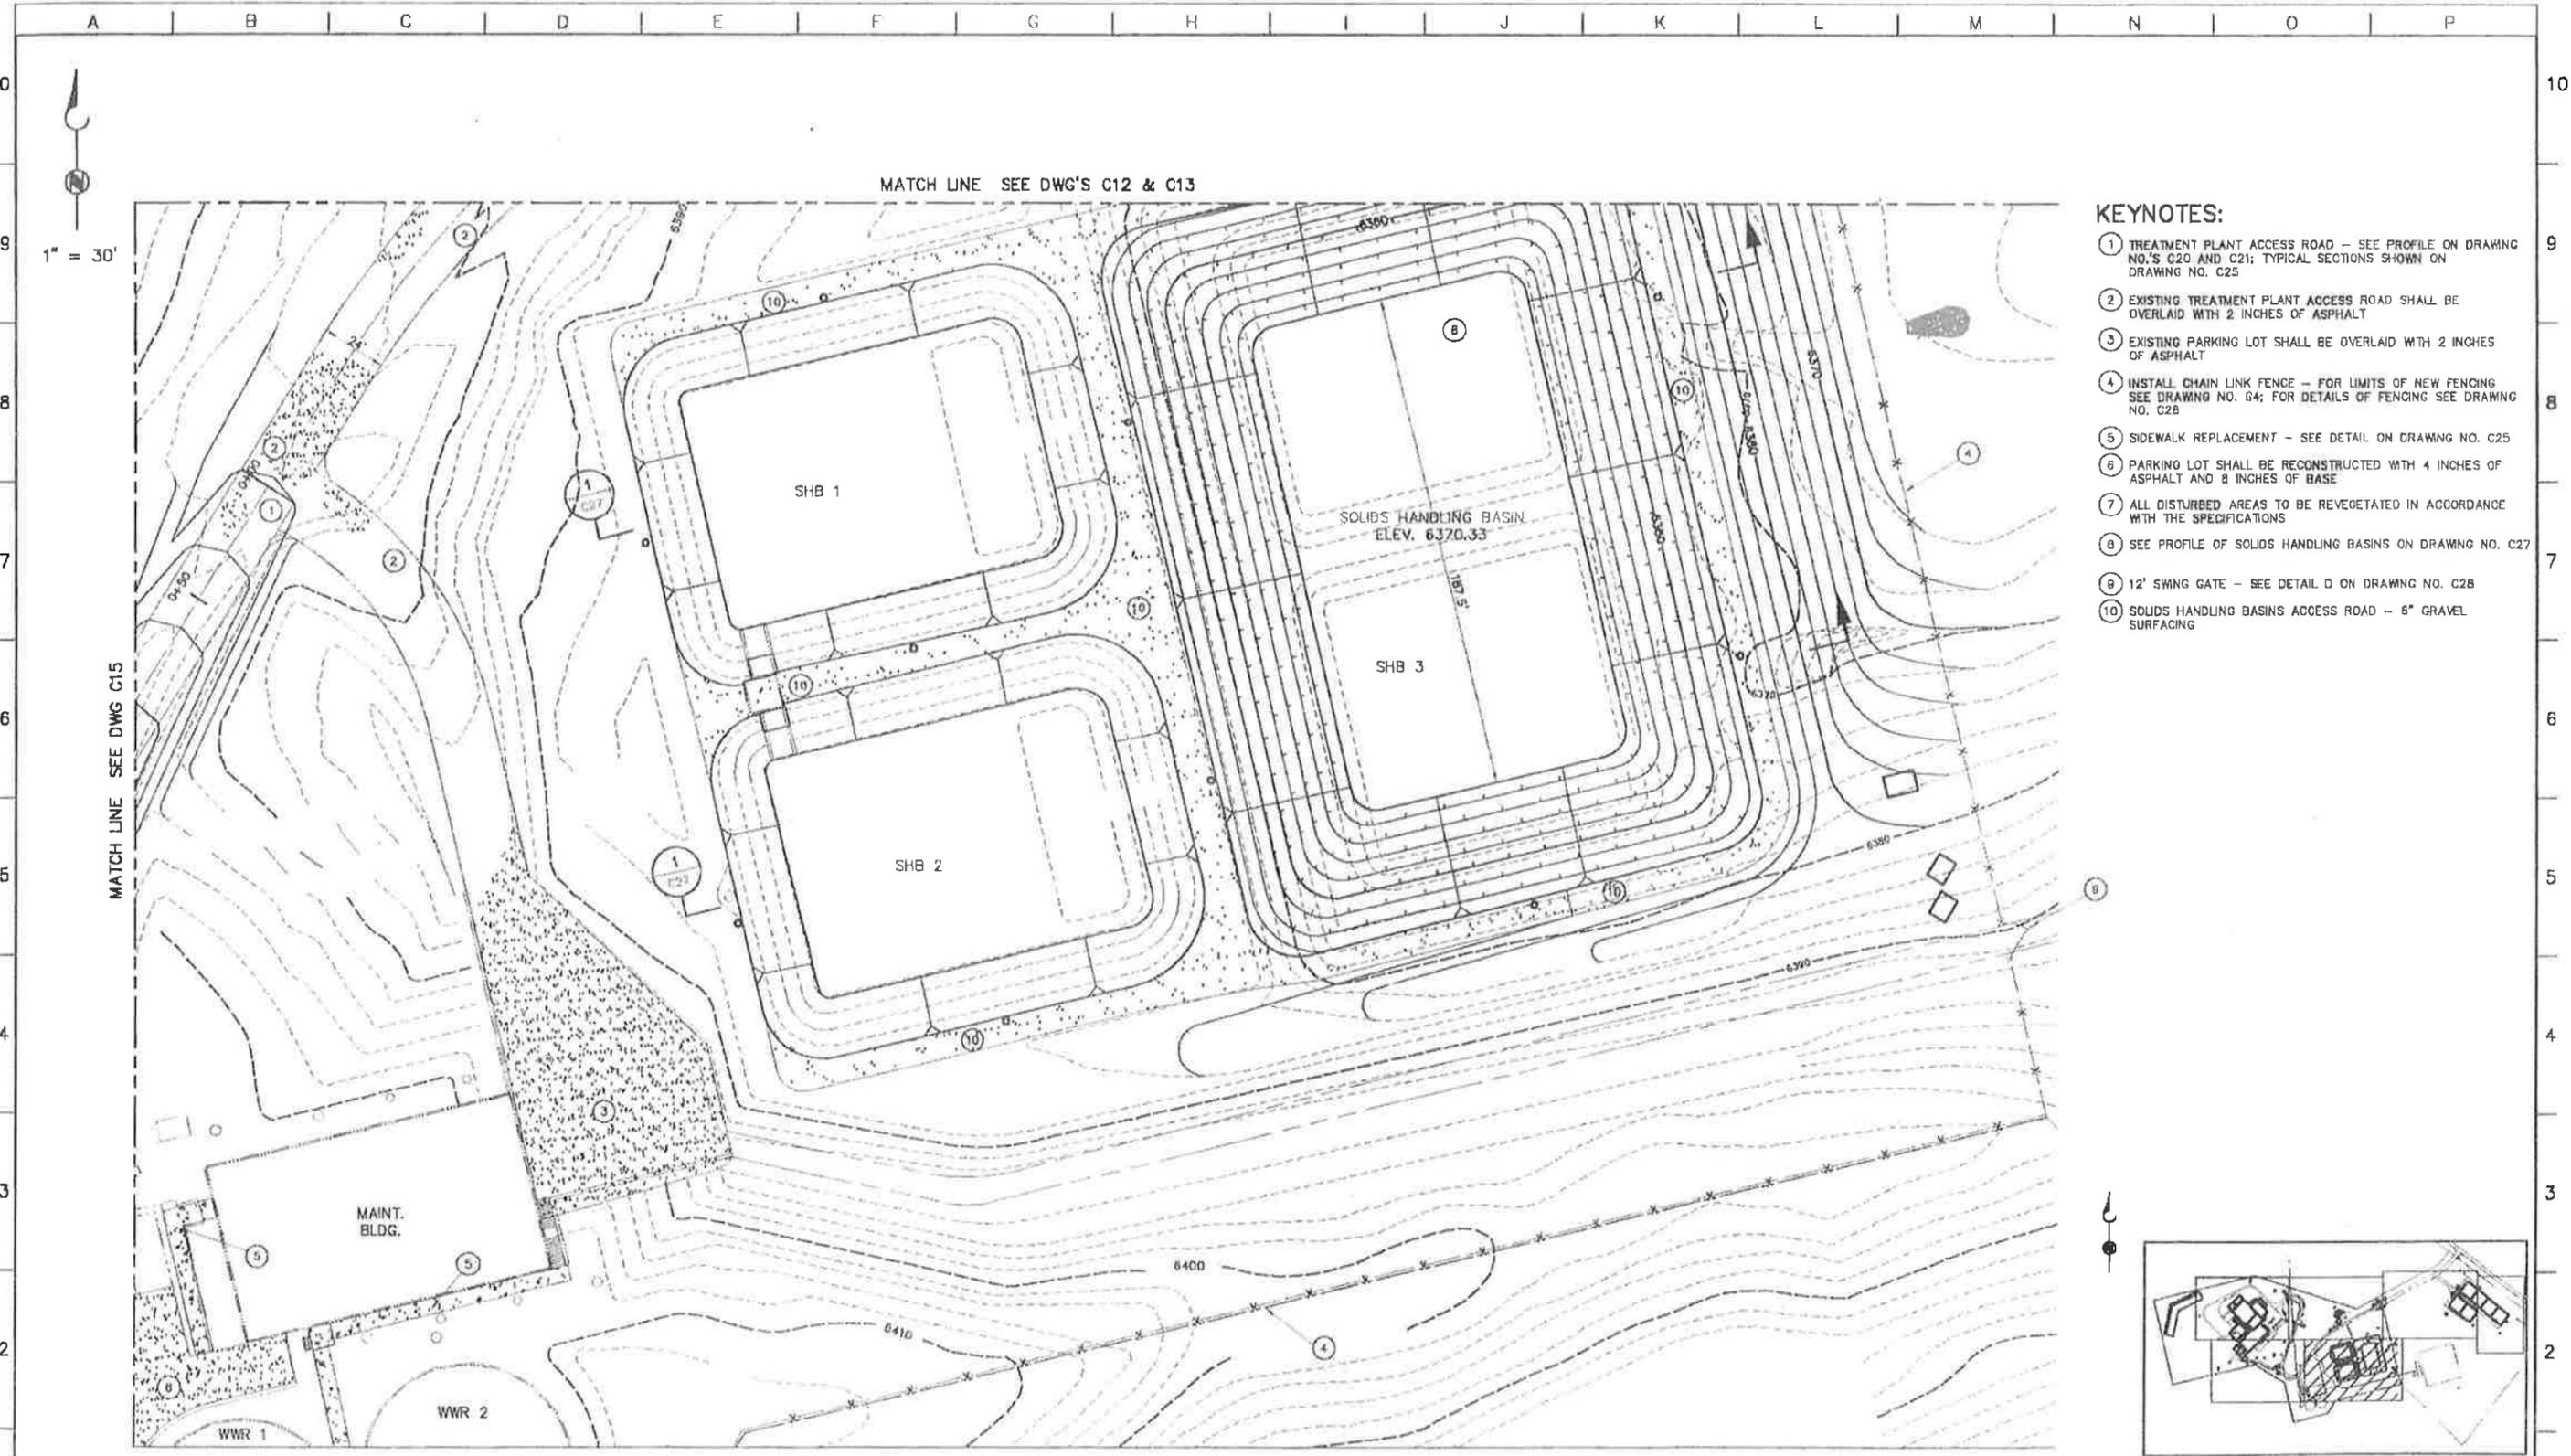

**BROWN AND CALDWELL**  
 STATES WEST WATER RESOURCES CORPORATION

FILE 6312  
 DRAWN BY JPC  
 DESIGNED BY JN  
 CHECKED BY PRELIM  
 CHECKED BY

LINE IS 2 INCHES AT FULL SIZE (IF NOT 2"=SCALE ACCORDINGLY)

**RECORD DRAWINGS**  
 AS BUILT INFORMATION PROVIDED BY DANIS ENVIRONMENTAL INDUSTRIES

REVISIONS					
ZONE	REV.	DESCRIPTION	BY	DATE	APP.

CHEYENNE, WYOMING  
 BOARD OF PUBLIC UTILITIES

**R. L. SHERARD WATER TREATMENT PLANT EXPANSION**

CIVIL  
**PAVING AND GRADING PLAN**  
 AREA 6

CADFILE C6312218  
 DATE 01-07-99  
 OPERATOR JPC

DRAWING NO.  
**C16**

SHEET NUMBER  
 OF